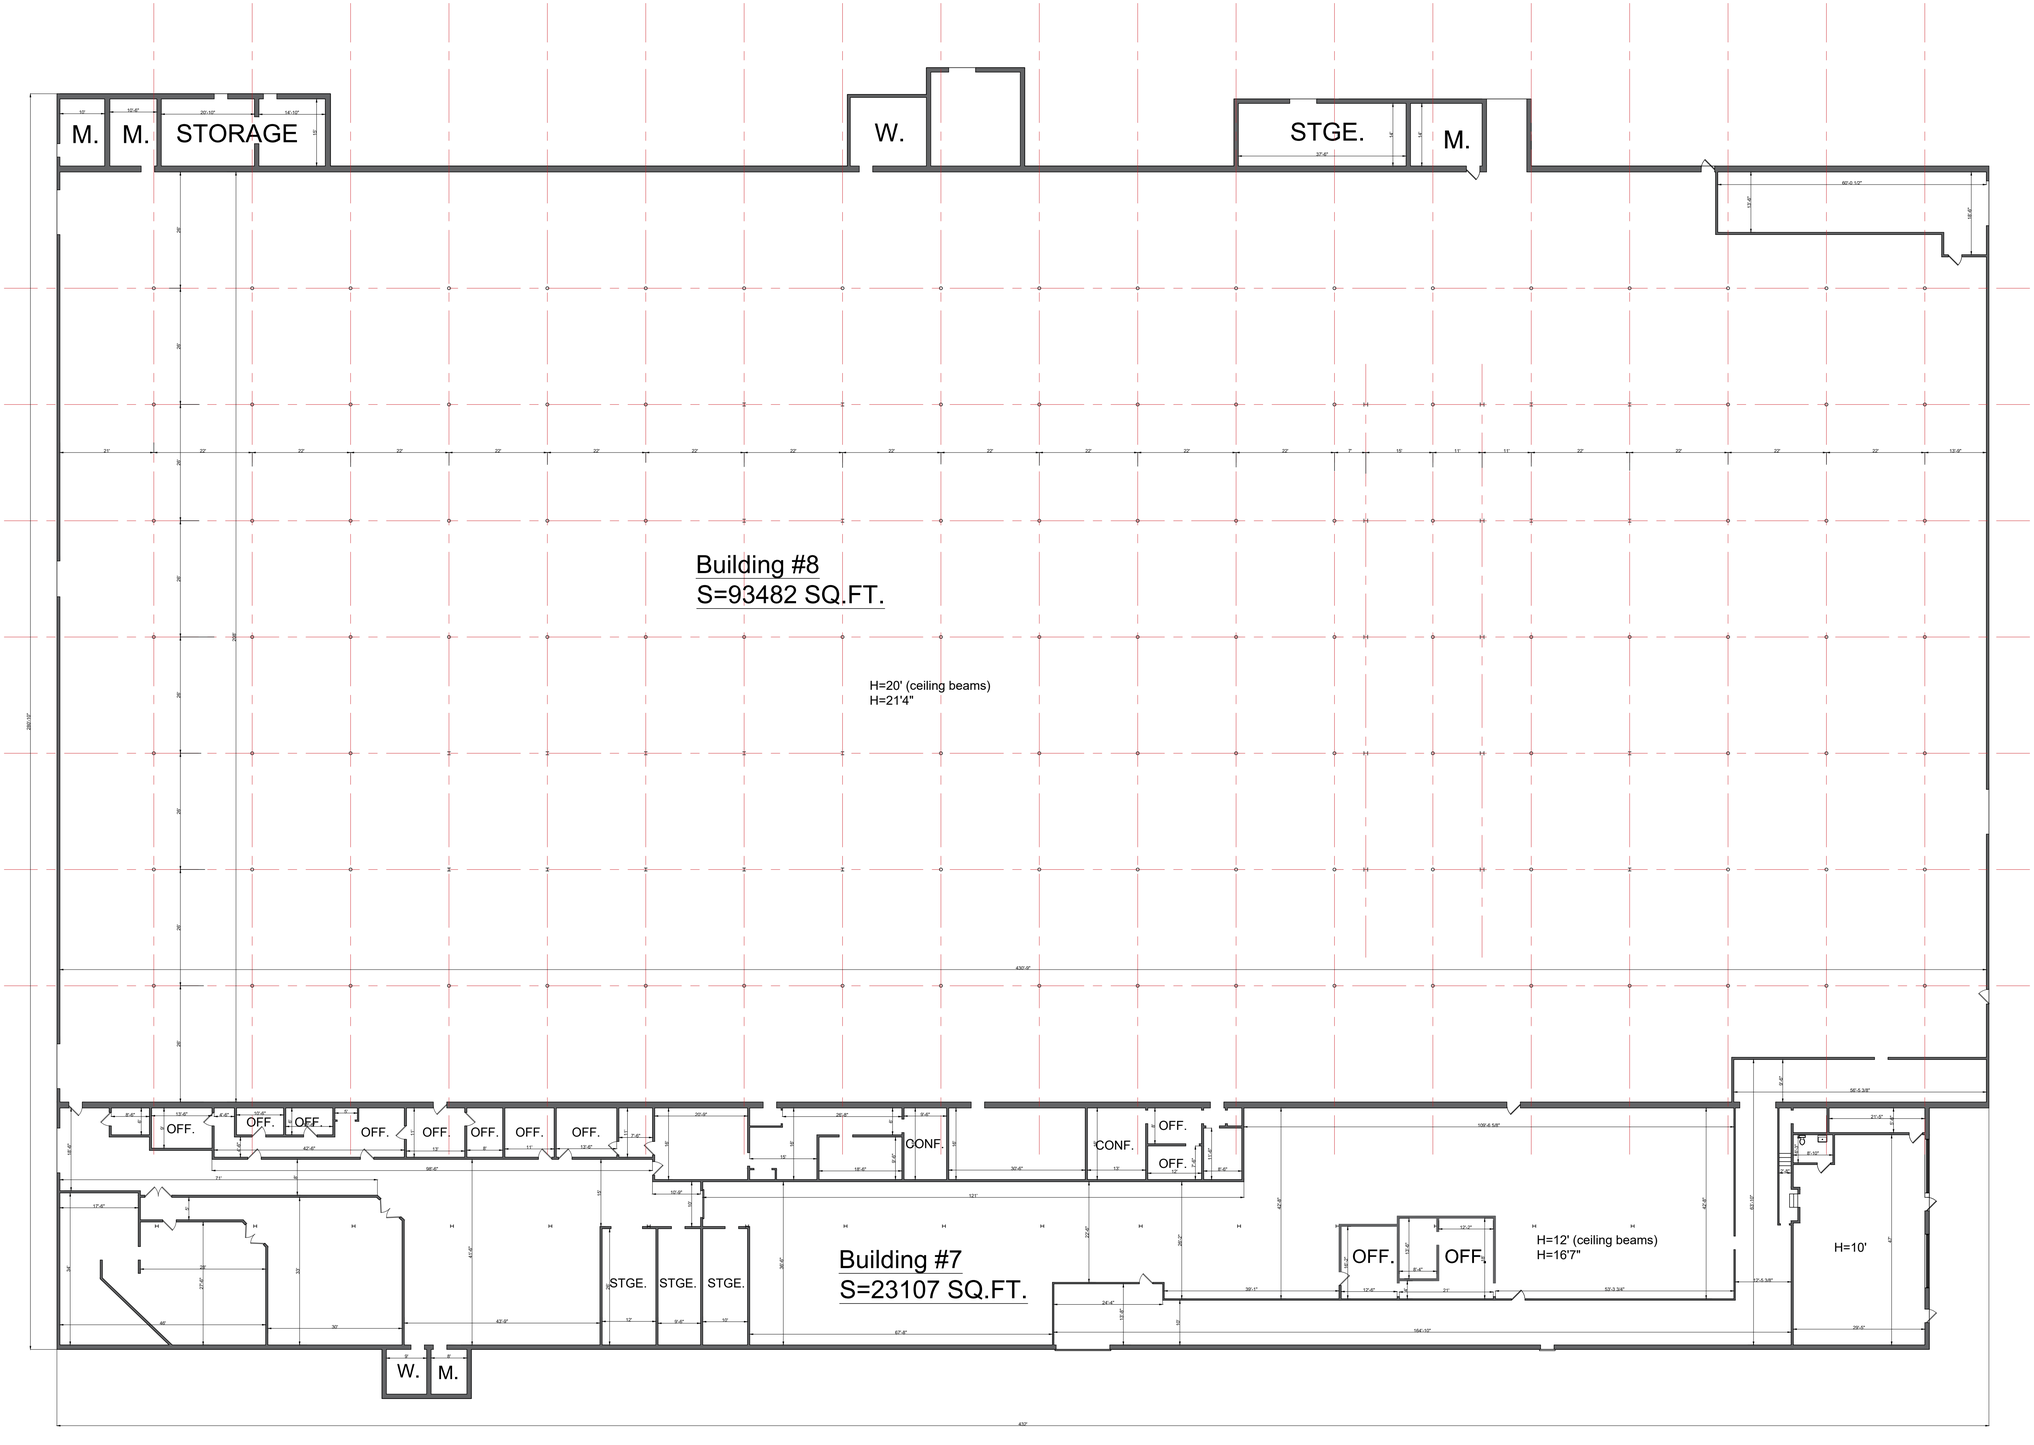


DOCUMENTATION & DETAILING

Plan A Services Inc.
70 Gilbert St,
Monroe, NY 10950

718.219.4749

info@planaservices.com
planaservices.com

Project

100 N 13th St,
Erwin, NC 28339

Drawing

First floor
Building #3 space plan

A — B As-built Floor Plans

A - 002.03

Area

Scale 1/16":1'

Date 3/18/2024

Drawn By M.O.

Notes